3D View

Do not scale

Notes:

- Foundation design by others (specialist sub-contractor).
Arup's design responsibility stops at the super structure and does not include foundation design.

- All steel to be grade E350 unless noted otherwise. Architectural setting out of Safdarjung Station and platforms by others.

Drawings to be read together with the latest revision of Structural Specification 284197-ARP-ZZ-ZZ-RP-ZX-000005.

- All dimensions are in millimetres (mm) and all levels are in metres (m), unless noted otherwise.

- No dimensions shall be scaled from this drawing Fabrication / shop drawings shall be approved by the Engineer prior to commencing fabrication.

**ARUP** 

01 | 14/11/23 | For information

Arup IP Limited Off Western Express Highway Andheri (East) 5th Floor Jet Prime Suren Road Mumbai www.arup.com

Issue Date

Rail Land Development Authority Ministry of Railways

Innovative Design of Modular Railway Station Components in Brownfield Projects Safdarjung Station

Drawing Title


General Arrangement Rendered 3d View

	28419	7		01
Aı	rup Job No			Rev
St	tatus	S4 - Submission		
R	ole	Structural		
So	cale at A1	1:200		hkd/Appd EB/FA&FE

284197-ARP-ZZ-ZZ-DR-SX-000501

The 3D drawings were sent for information only and have not been updated - refer to Tekla model for the latest geometry (Arup, 26/04/2024)

By: Himanshu Singhal
Date: 16-05-2024

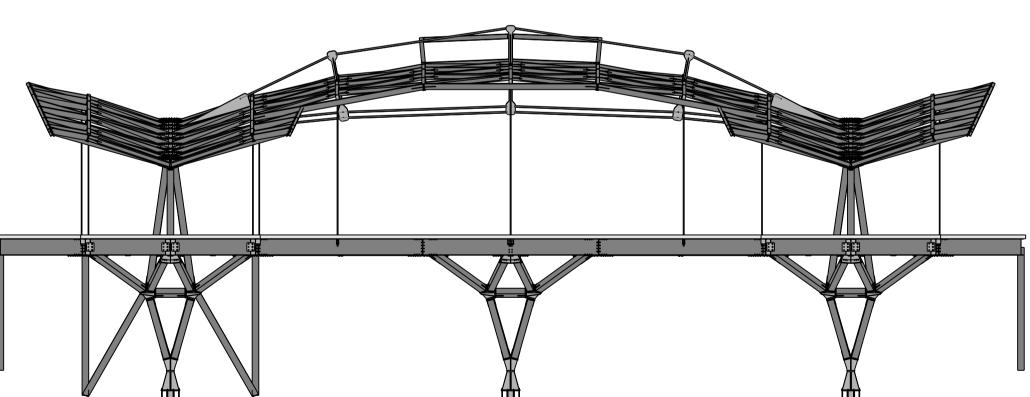

Front Elevation



The 3D drawings were sent for information only and have not been updated - refer to Tekla model for the latest geometry (Arup, 26/04/2024)

Notes:

- Foundation design by others (specialist sub-contractor).

Arup's design responsibility stops at the super structure and does not include foundation design. - All steel to be grade E350 unless noted otherwise.

Architectural setting out of Safdarjung Station and platforms by others.

Drawings to be read together with the latest revision of Structural Specification 284197-ARP-ZZ-ZZ-RP-ZX-000005.

- All dimensions are in millimetres (mm) and all levels are in metres (m), unless noted otherwise.

- No dimensions shall be scaled from this drawing Fabrication / shop drawings shall be approved by the Engineer prior to commencing fabrication.

**ARUP** 

01 | 14/11/23 | For information

Arup IP Limited Off Western Express Highway Andheri (East) 5th Floor Jet Prime Suren Road Mumbai www.arup.com

Issue Date

Rail Land Development Authority Ministry of Railways

Innovative Design of Modular Railway Station Components in Brownfield Projects
Safdarjung Station

General Arrangement Rendered Elevations

28419	97		01
Arup Job No	)		Rev
Status	S4 - Submission		
Role	Structural		
Scale at A1	1:200	1 1	hkd/Appd EB/FA&FB

284197-ARP-ZZ-ZZ-DR-SX-000502

Do not scale

See section drawings SX-050501 - and Tekla model for the proper location of grids Truss detail Refer to SX-064518 Roof columns below. Refer SX-061503 to SX-061504 Roof columns below.
Refer SX-061503 to SX-061504 for details. · — - — - — - — - — - — - <del>|</del> ----<del>-</del> -----<del>G</del>\* C\* SX-064515\_ Roof columns below. -Refer SX-061503 to SX-061504 (TG) Roof columns below.

Refer SX-061503 to SX-061504 ⊂Truss detail Refer to SX-064518 SX-064517 Roof columns below. -Refer SX-064519 Refer SX-064519 for details. \_\_\_\_ for details. The extent of roof TBC and finalised as the cladding contractor comes Roof Plan Scale 1:200

Do not scale

Notes:

Foundation design by others (specialist sub-contractor). Arup's design responsibility stops at the super structure and does not include foundation design.
All steel to be grade E350 unless noted otherwise.

All steel to be grade E350 unless noted otherwise.
Architectural setting out of Safdarjung Station and platforms by others.

 Drawings to be read together with the latest revision of Structural Specification 284197-ARP-ZZ-ZZ-RP-ZX-000005.

All dimensions are in millimetres (mm) and all levels are in metres (m), unless noted otherwise.
No dimensions shall be scaled from this drawing

No dimensions shall be scaled from this drawing
 Fabrication / shop drawings shall be approved by the Engineer prior to commencing fabrication.





03	19/06/24	Good for Construction
02	09/02/24	Good for Construction
01	14/11/23	Good for Construction
Issue	Date	

## ARUP

Arup IP Limited Off Western Express Highway Andheri (East) 5th Floor Jet Prime Suren Road Mumbai www.arup.com

www.arup.com

Rail Land Development Authority Ministry of Railways

Project Title

Innovative Design of Modular Railway Station Components in Brownfield Projects Safdarjung Station


> awing Title eneral Arrange

General Arrangement Roof Steelwork Plan

28419	7		03
Arup Job No			Rev
Status	S4 - Submission		
Role	Structural		
Scale at A1	1:200	By/C PG/I	hkd/Appd EB/FA&FE

284197-ARP-ZZ-02-DR-SX-024505


PRECISE SETTING OUT GEOMETRY TO BE READ FROM TEKLA MODEL

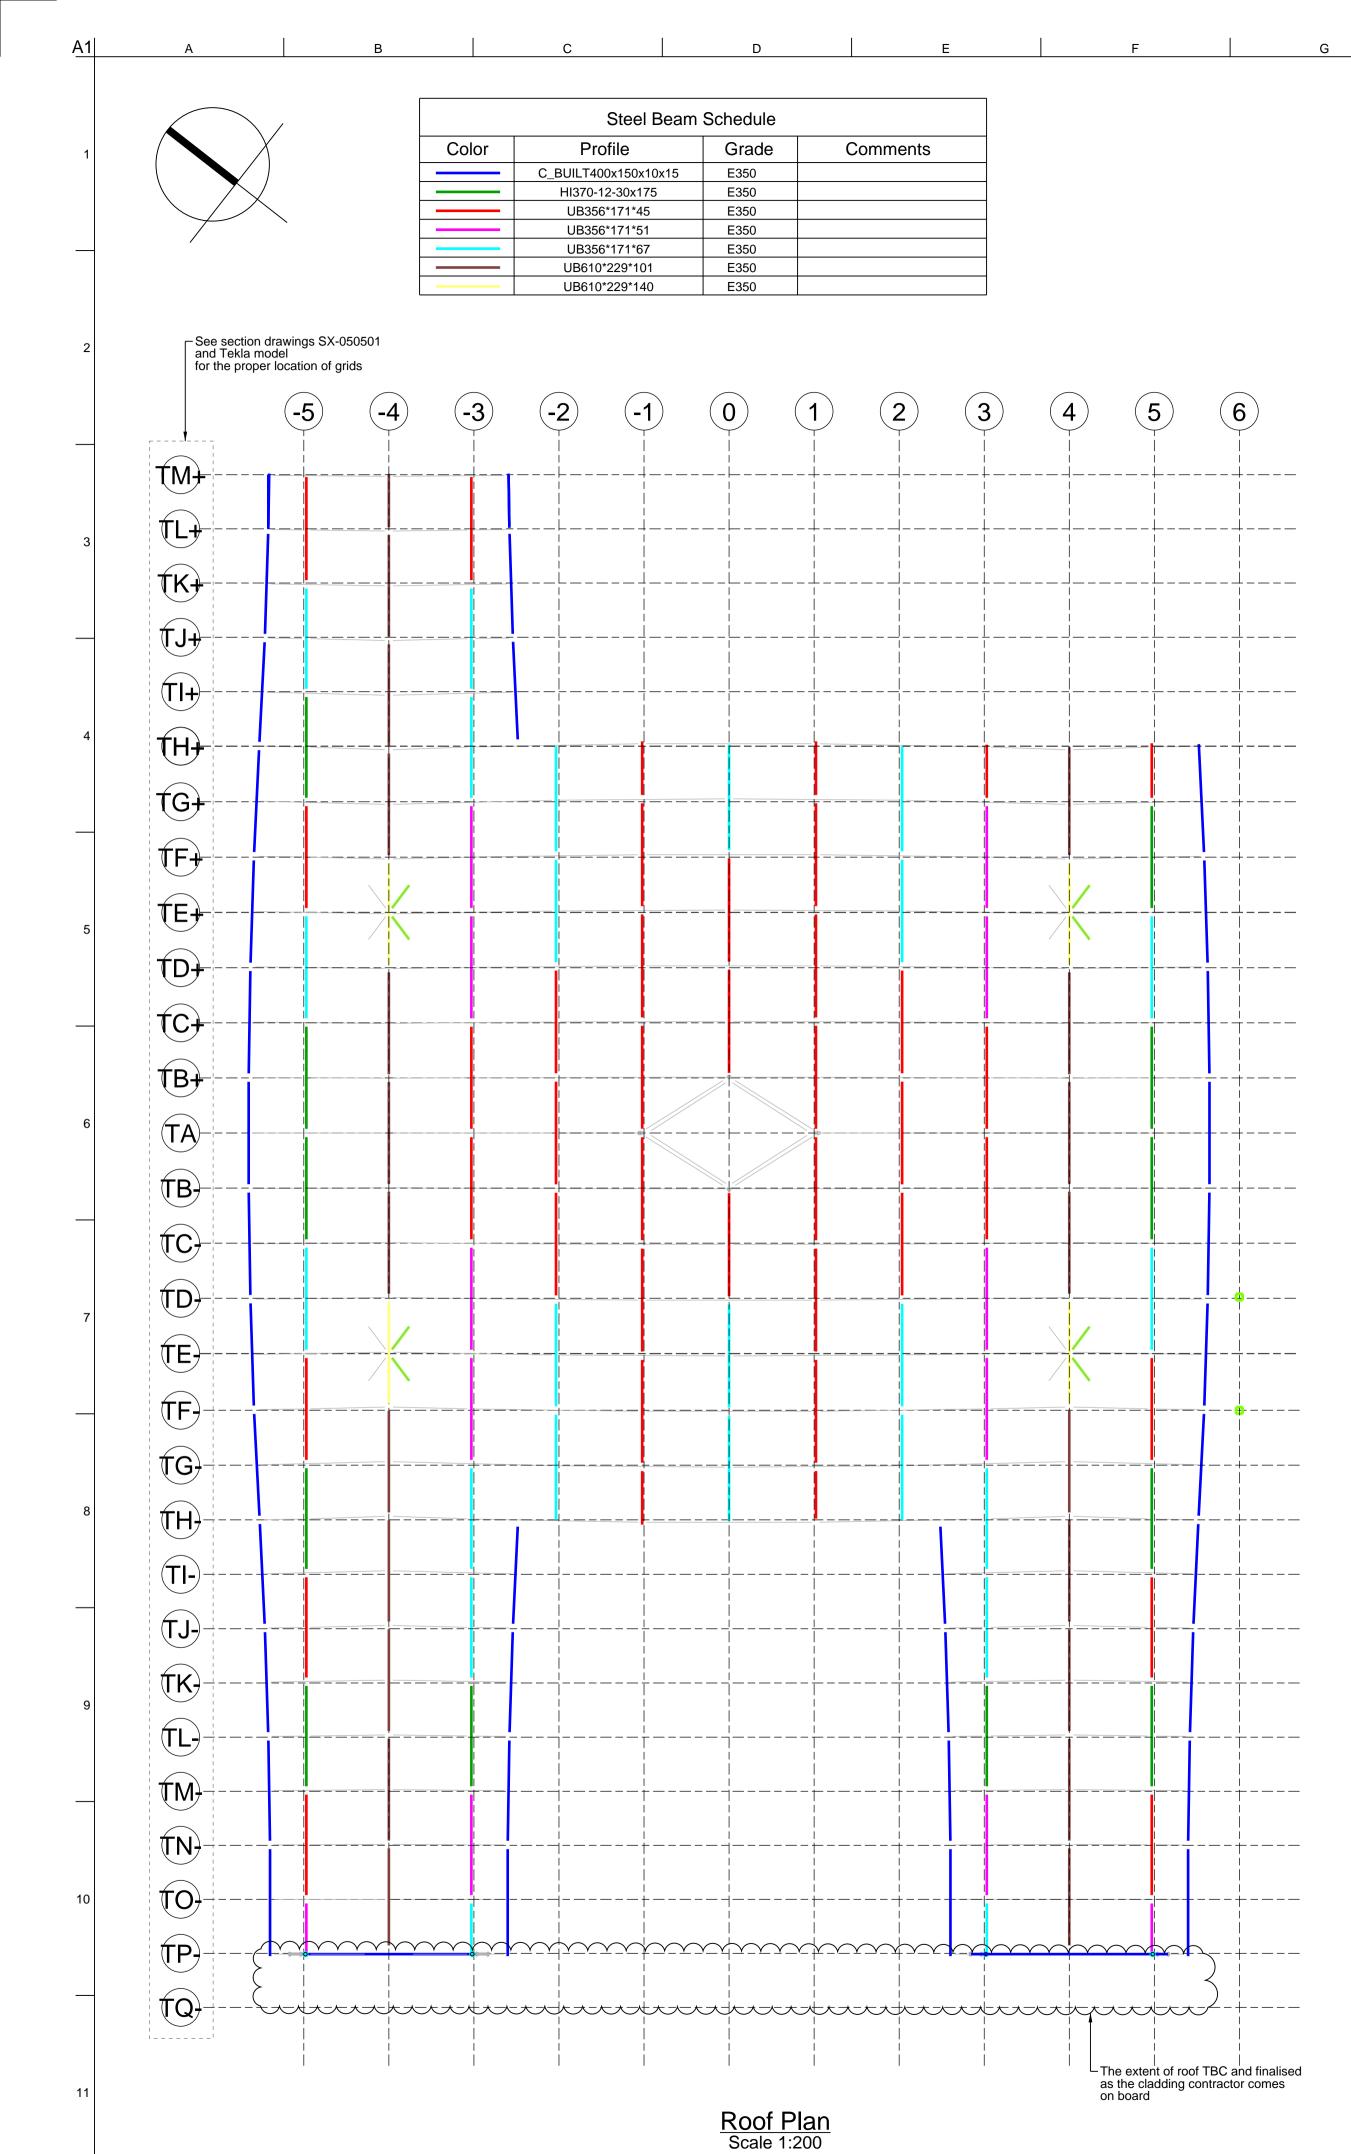

Do not scale

	Steel Beam	Schedule	
Color	Profile	Grade	Comments
	B_WLD_F300x300x30x30	E350	
	SHS300*300*6.3	E350	
	SHS300*300*10.0	E350	
	SHS300*300*16.0	E350	

	St	teel Bra	cing Scl	hedule				
Color	Profile	Grade		En	d Conne	ctions		
			End connection plate thickness	Width of connection plate	Length of overlap of connecting plate with CHS	CHS end plate thickness	fillet weld between connecting plate and CHS	Number and size of bolts
	CHS193.7*6.3	E350	20	220	250	8	6	4xM30
	CHS193.7x10	E350	30	220	250	8	12	4xM30
	CHS193.7x10	E350	30	220	250	8	12	4xM30
	CHS193.7x10	E350	35	220	250	8	12	5xM3

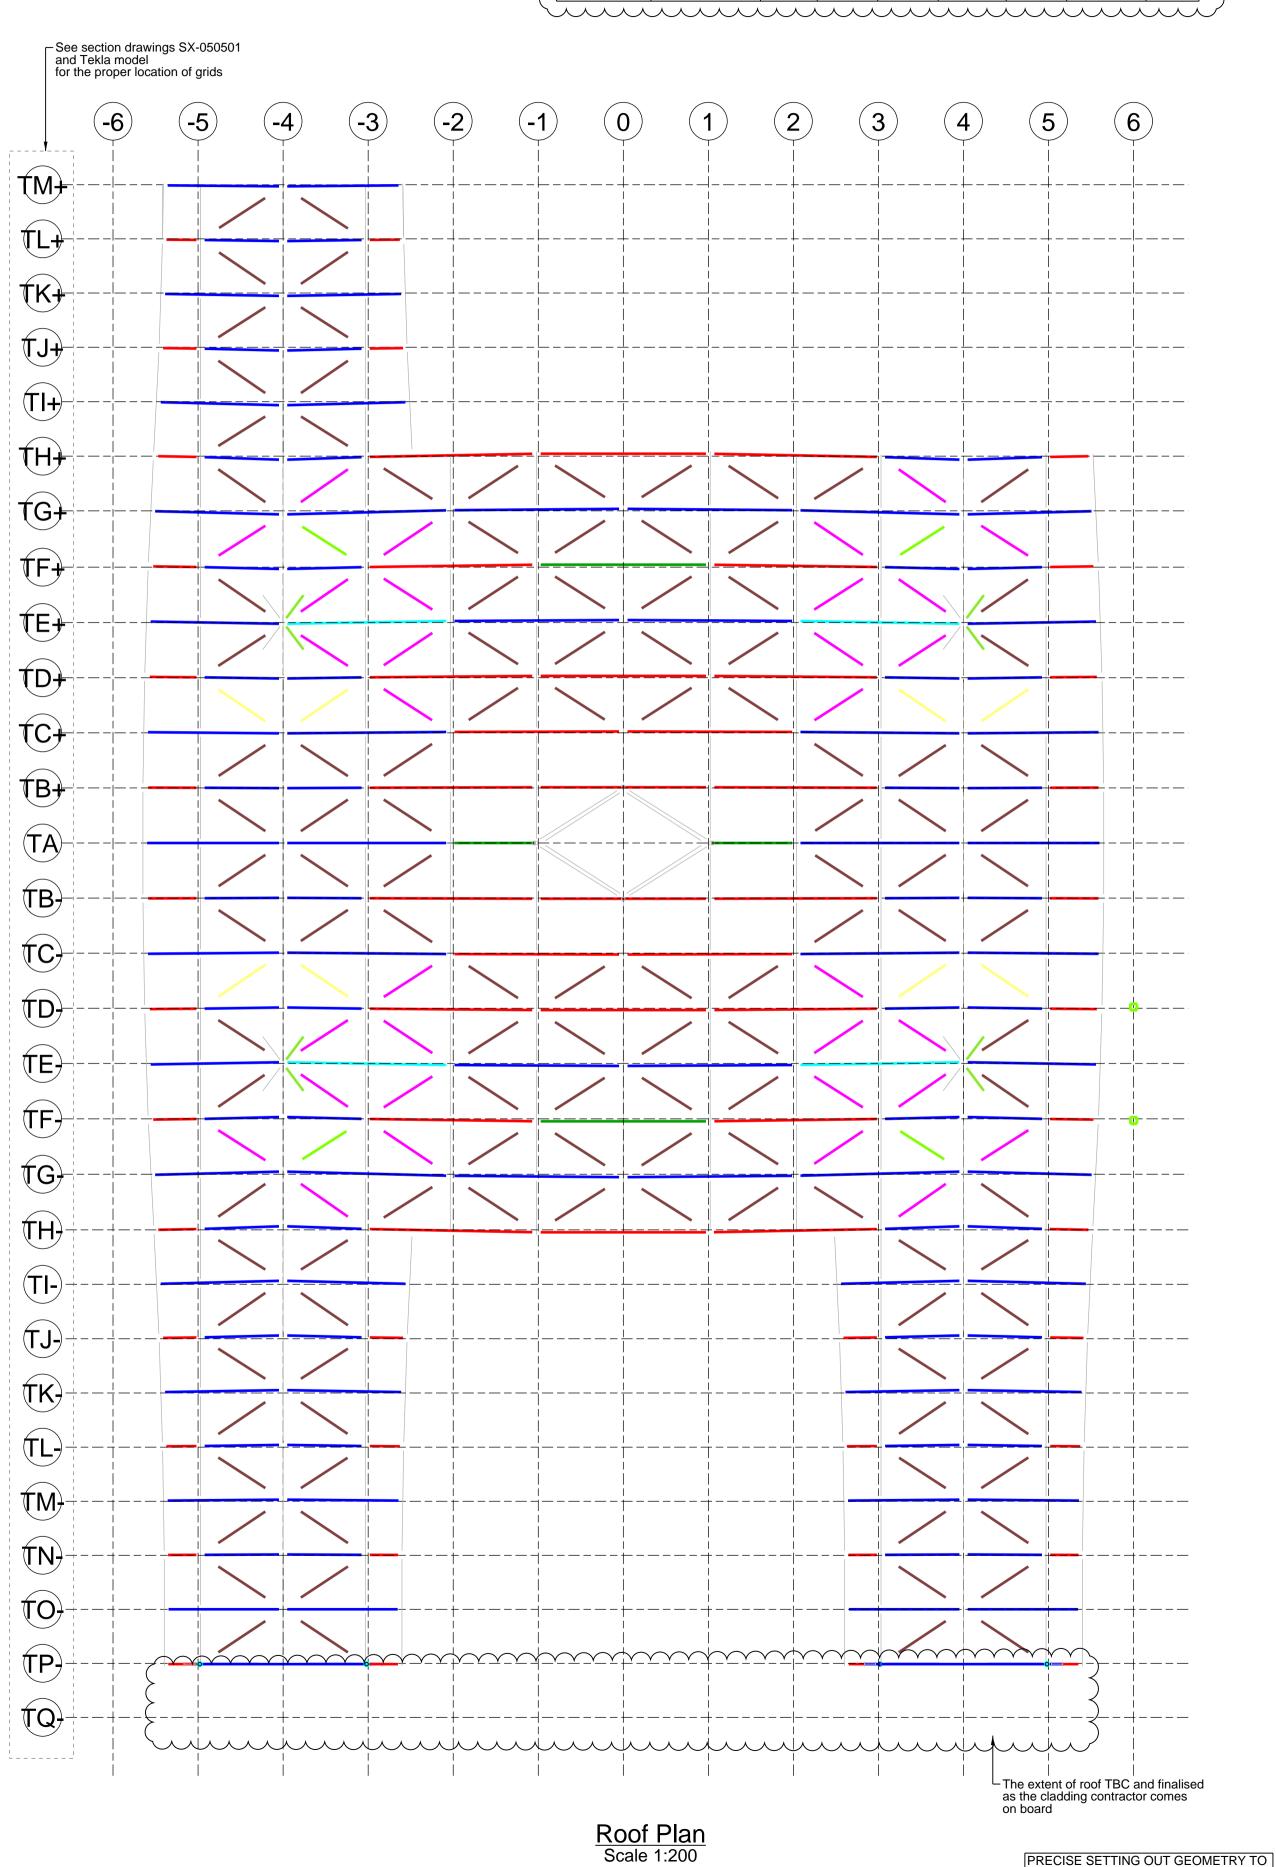



Foundation design by others (specialist sub-contractor).
 Arup's design responsibility stops at the super structure and does not include foundation design.

- All steel to be grade E350 unless noted otherwise. - Architectural setting out of Safdarjung Station and platforms by others.

 Drawings to be read together with the latest revision of Structural Specification 284197-ARP-ZZ-ZZ-RP-ZX-000005. - All dimensions are in millimetres (mm) and all levels

are in metres (m), unless noted otherwise. - No dimensions shall be scaled from this drawing Fabrication / shop drawings shall be approved by the Engineer prior to commencing fabrication.





03   19/0	06/24   Go	ood for construction
02   09/0	02/24   Go	ood for construction
01   14/	11/23   Go	ood for construction
Issue D	ate	

## **ARUP**

Arup IP Limited Off Western Express Highway Andheri (East) 5th Floor Jet Prime Suren Road Mumbai www.arup.com


Rail Land Development Authority Ministry of Railways

Innovative Design of Modular Railway Station Components in Brownfield Projects Safdarjung Station


PRECISE SETTING OUT GEOMETRY TO BE READ FROM TEKLA MODEL

General Arrangement Roof Sections Schedule

2841	97	03
Arup Job I		Rev
Status	S4 - Submission	
Role	Structural	
Scale at A	<sup>41</sup> 1:200	By/Chkd/Appd PB/EB/FA&FB

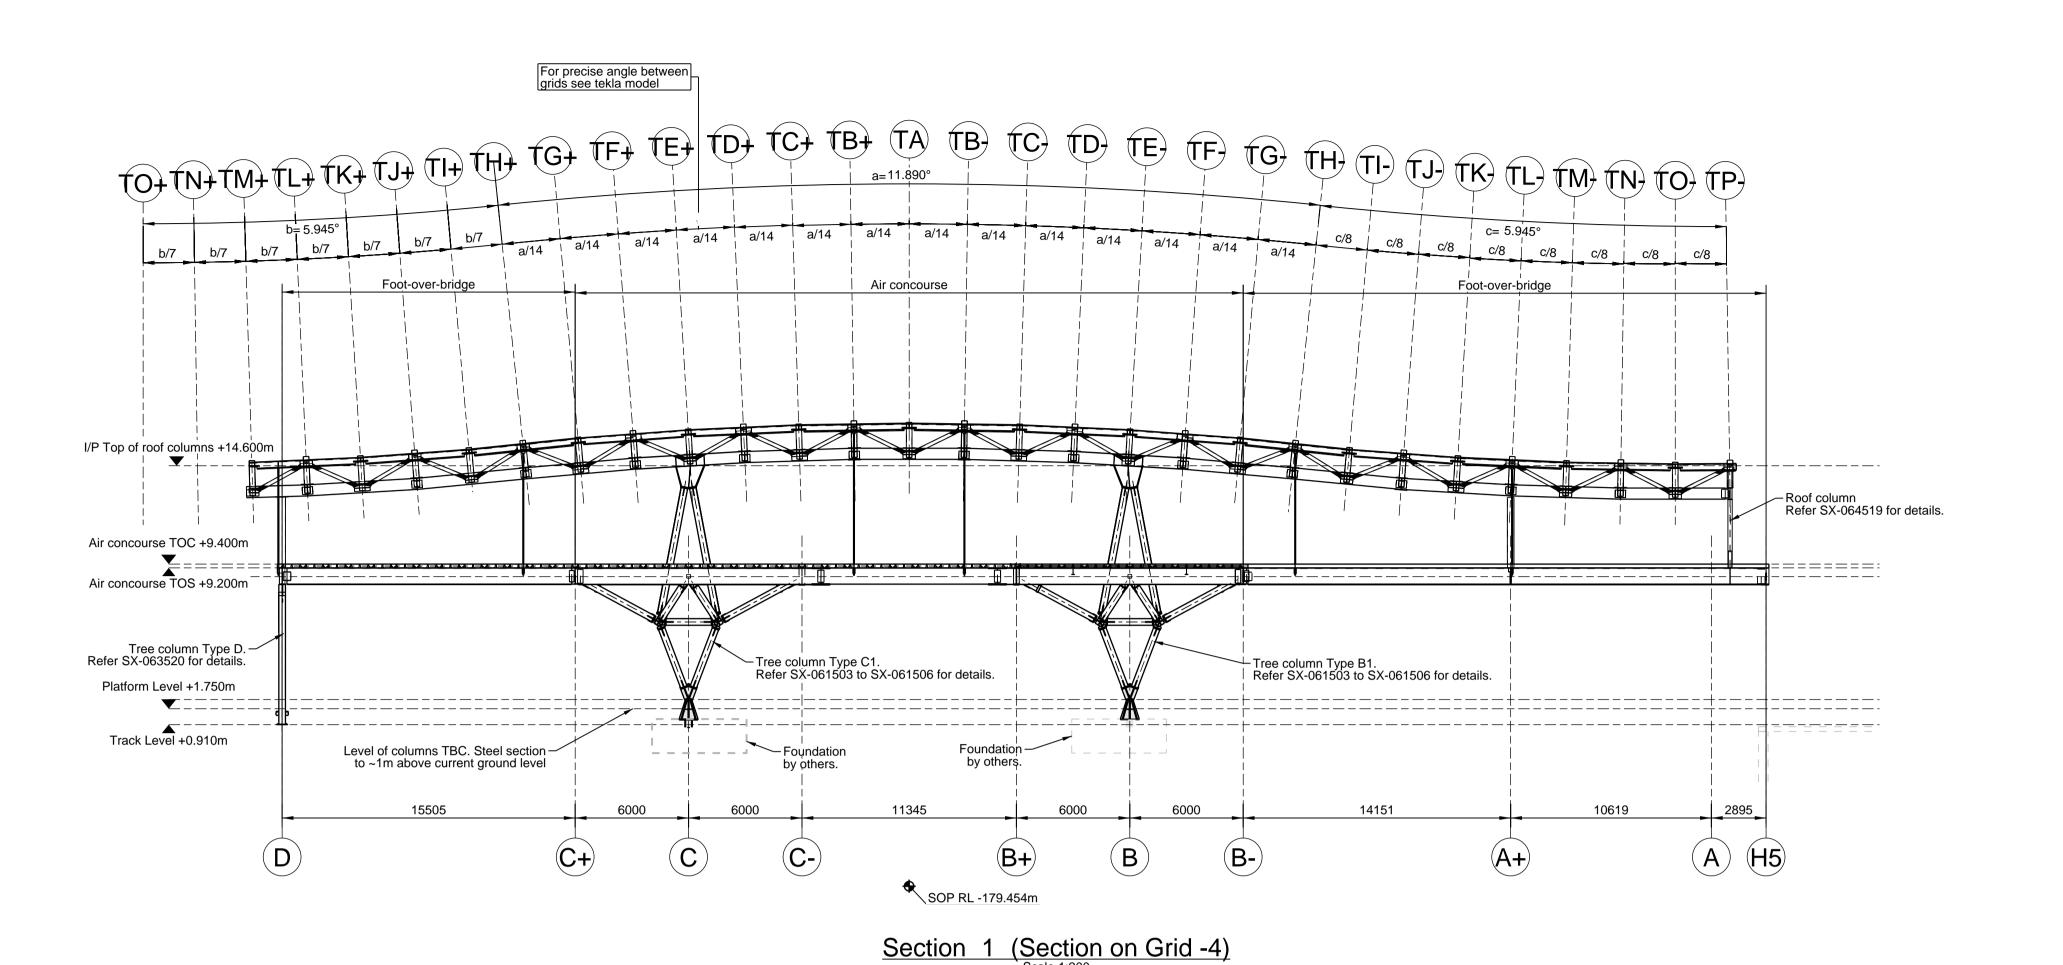

(SX-024505)

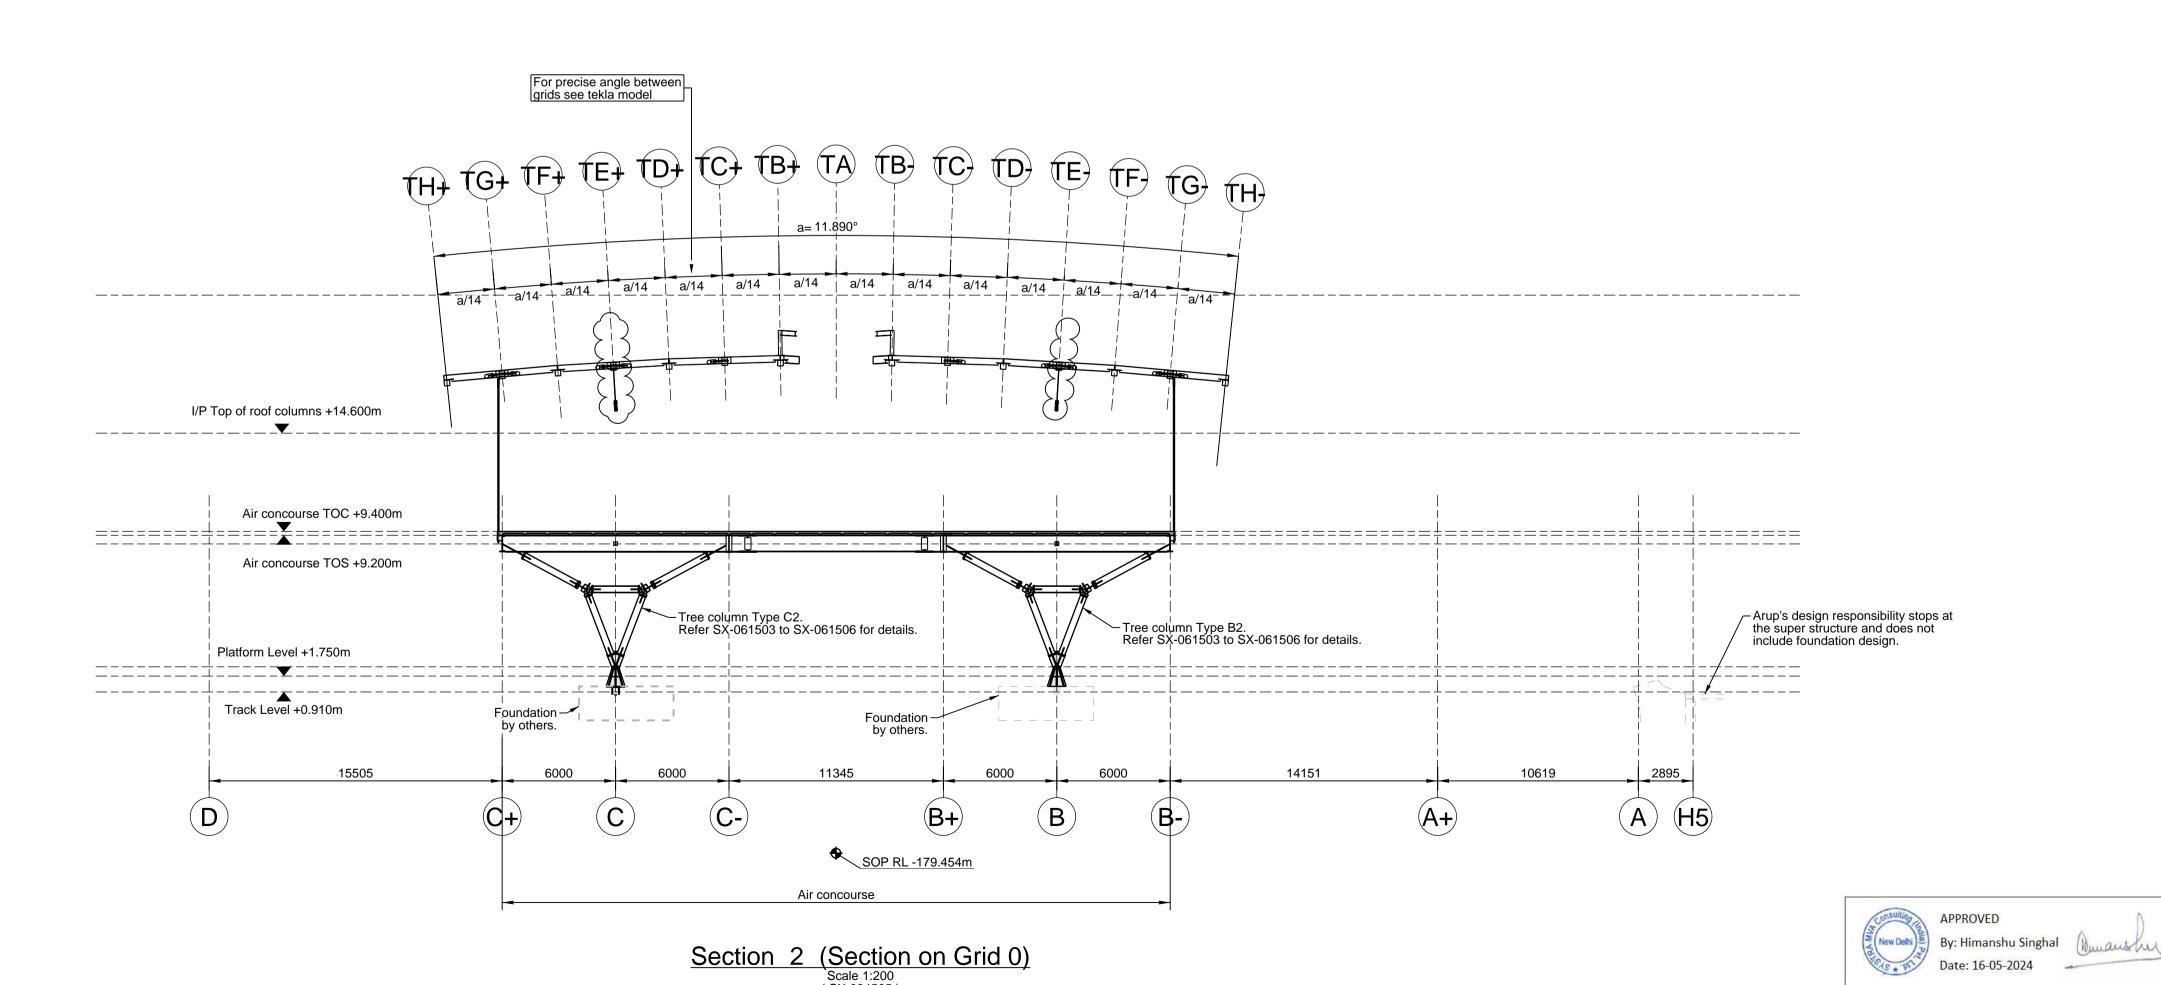

(SX-024505)

Do not scale

Notes:

platforms by others.

Foundation design by others (specialist sub-contractor).
 Arup's design responsibility stops at the super structure and does not include foundation design.

- All steel to be grade E350 unless noted otherwise.

- Architectural setting out of Safdarjung Station and

- Drawings to be read together with the latest revision

- All dimensions are in millimetres (mm) and all levels

- Fabrication / shop drawings shall be approved by the

- No dimensions shall be scaled from this drawing

of Structural Specification 284197-ARP-ZZ-ZZ-RP-ZX-000005.

are in metres (m), unless noted otherwise.

Engineer prior to commencing fabrication.

GOOD FOR CONSTRUCTION

By: Francis Archer

Date: 20-03-2024

03 | 20/03/24 | Good for construction 02 | 09/02/24 | Good for construction 01 | 14/11/23 | Good for construction Issue Date

## **ARUP**

Arup IP Limited Off Western Express Highway Andheri (East) 5th Floor Jet Prime Suren Road Mumbai www.arup.com

Rail Land Development Authority

Ministry of Railways


Innovative Design of Modular Railway Station Components in Brownfield Projects Safdarjung Station

Drawing Title

**Building Sections** Sections Sheet 1

2841	97	03
Arup Job I	No	Rev
Status	S4 - Submission	
Role	Structural	
Scale at A	1:200	kd/Appd B/FA&FE

PRECISE SETTING OUT GEOMETRY TO BE READ FROM TEKLA MODEL 284197-ARP-ZZ-ZZ-DR-SX-050501

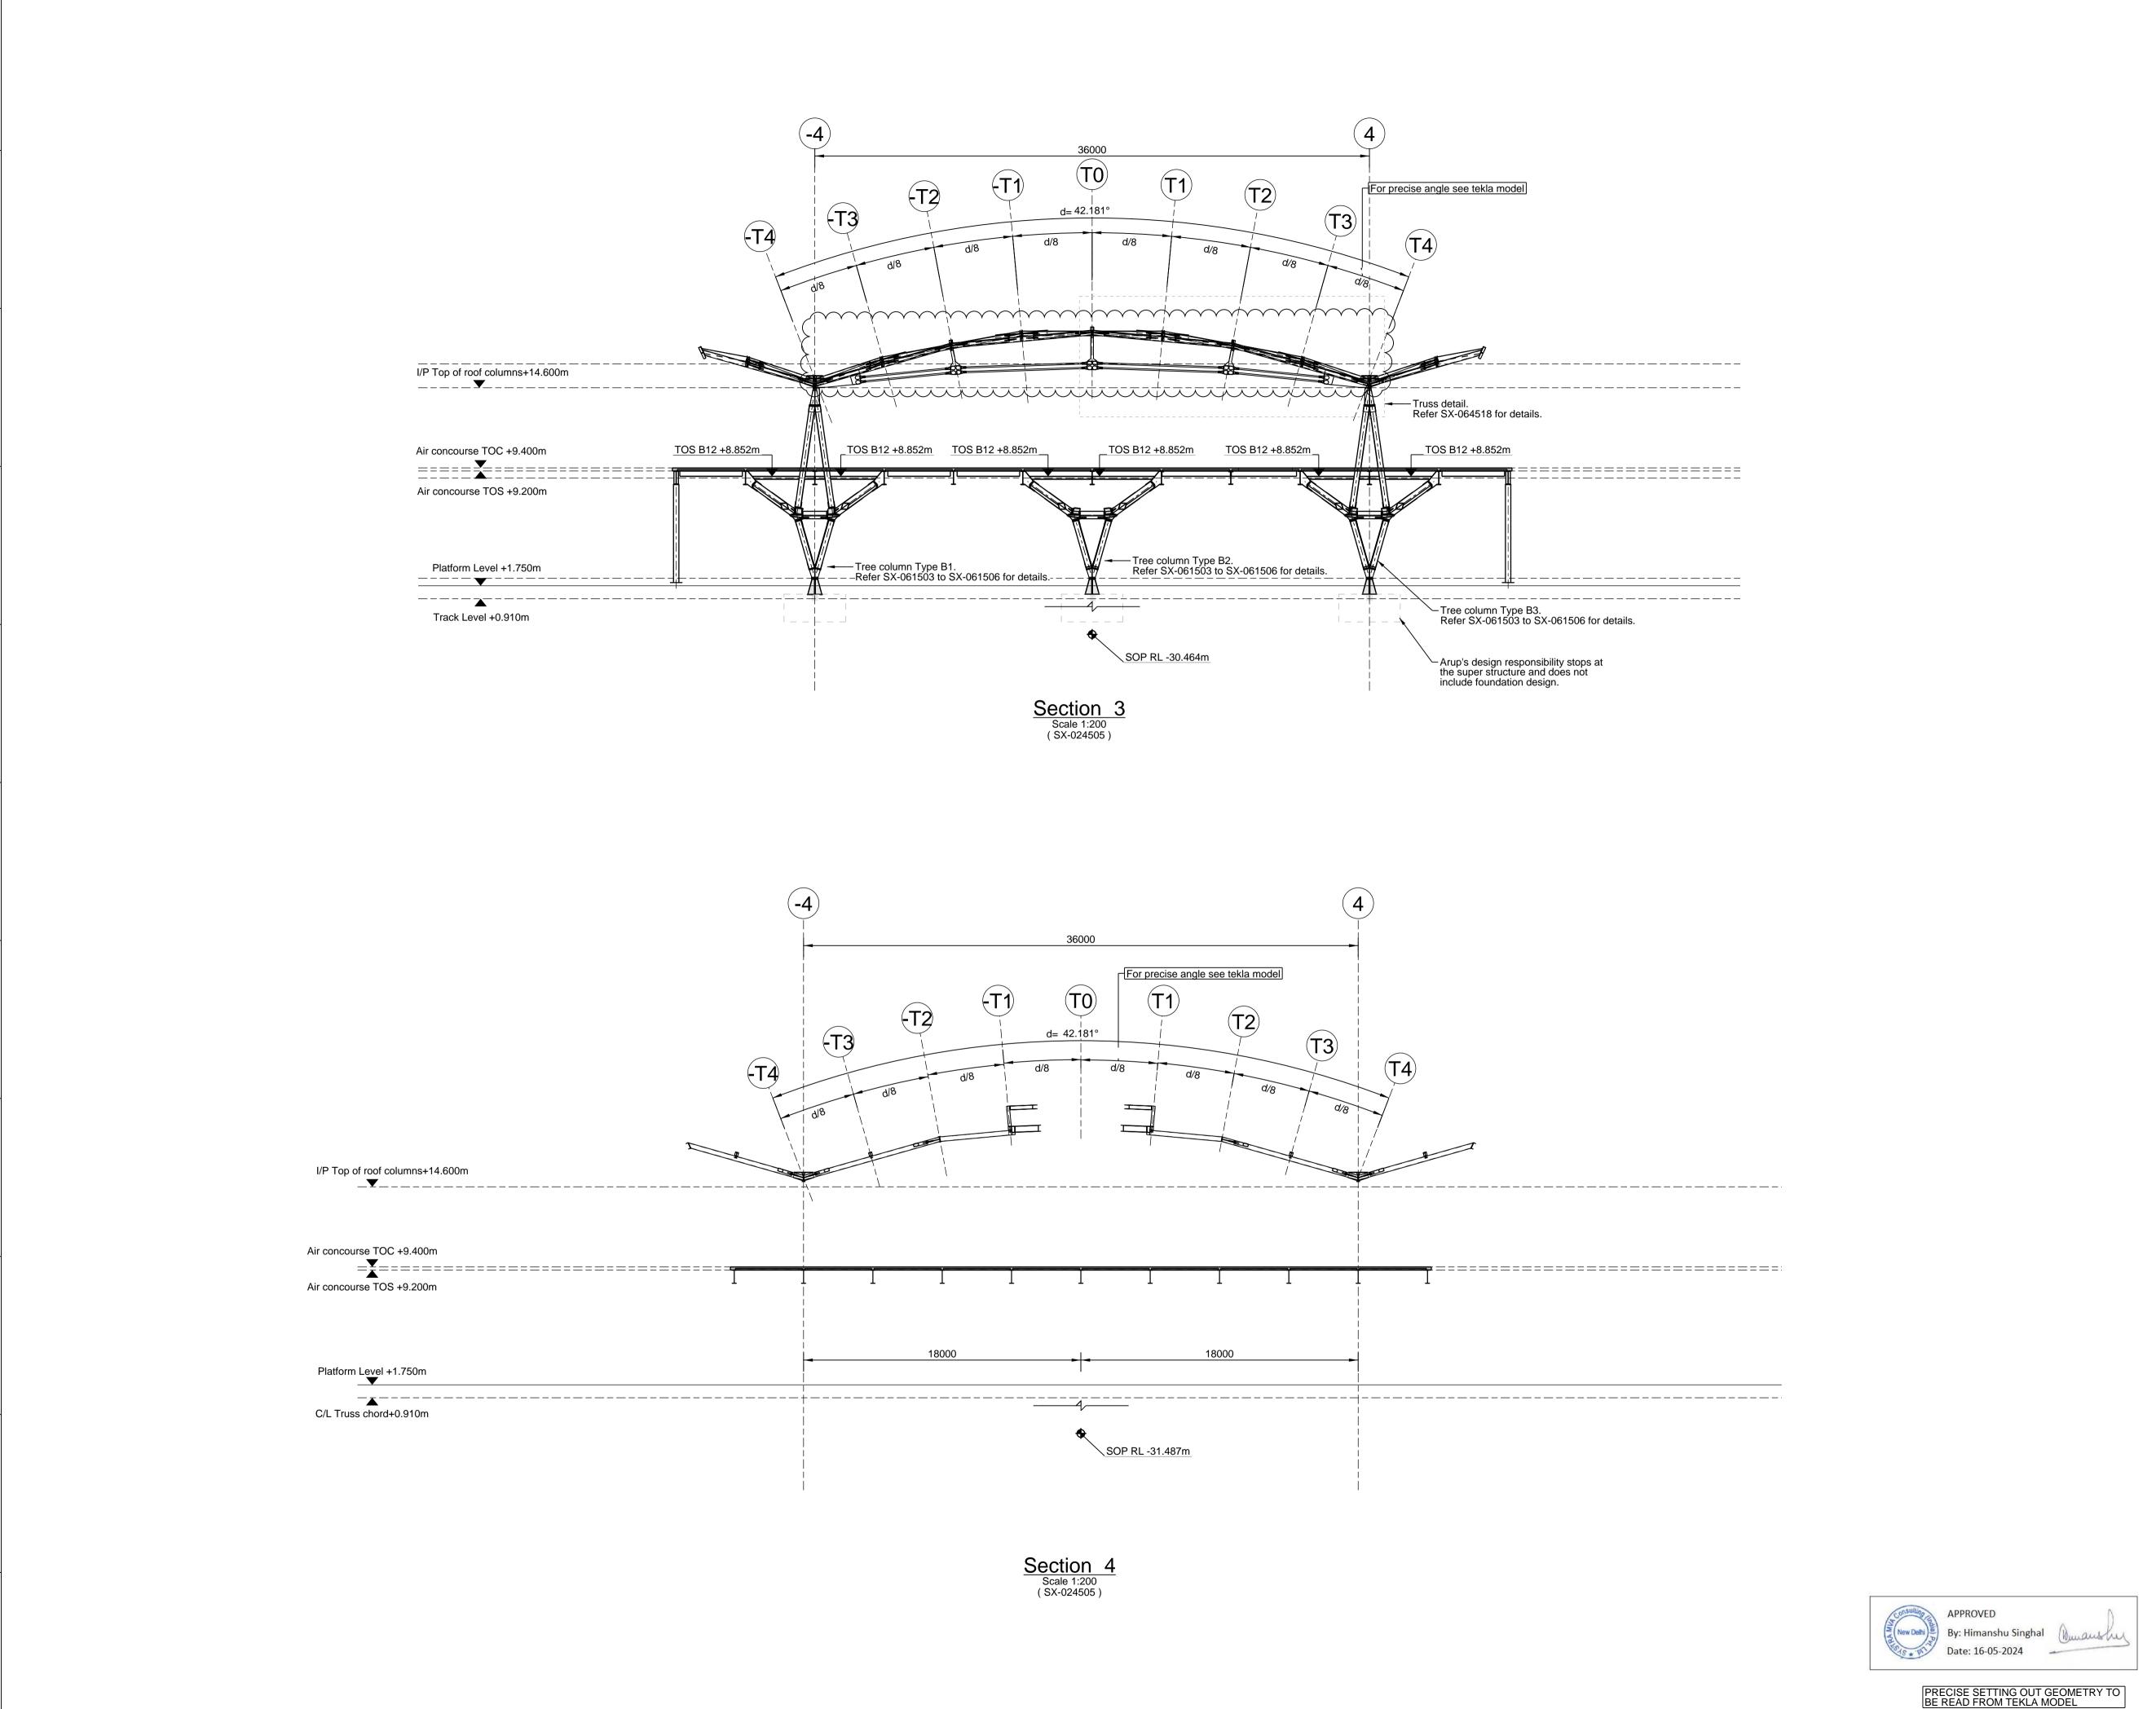

Do not scale

Notes:

 Foundation design by others (specialist sub-contractor).
 Arup's design responsibility stops at the super structure and does not include foundation design. - All steel to be grade E350 unless noted otherwise.

Architectural setting out of Safdarjung Station and platforms by others.

Drawings to be read together with the latest revision of Structural Specification 284197-ARP-ZZ-ZZ-RP-ZX-000005.

- All dimensions are in millimetres (mm) and all levels are in metres (m), unless noted otherwise. - No dimensions shall be scaled from this drawing Fabrication / shop drawings shall be approved by the Engineer prior to commencing fabrication.

GOOD FOR CONSTRUCTION

By: Francis Archer Date: 20-03-2024

02 | 20/03/24 | Good for construction 01 | 14/11/23 | Good for construction Issue Date

**ARUP** 

Arup IP Limited Off Western Express Highway Andheri (East) 5th Floor Jet Prime Suren Road Mumbai www.arup.com

Rail Land Development Authority Ministry of Railways


Innovative Design of Modular Railway Station Components in Brownfield Projects Safdarjung Station


Drawing Title


Building Sections Sections Sheet 2


28419	97	02
Arup Job No		Rev
Status	S4 - Submission	
Role	Structural	
Scale at A1	1:200	 y/Chkd/Appd B/EB/FA&FB


284197-ARP-ZZ-ZZ-DR-SX-050502

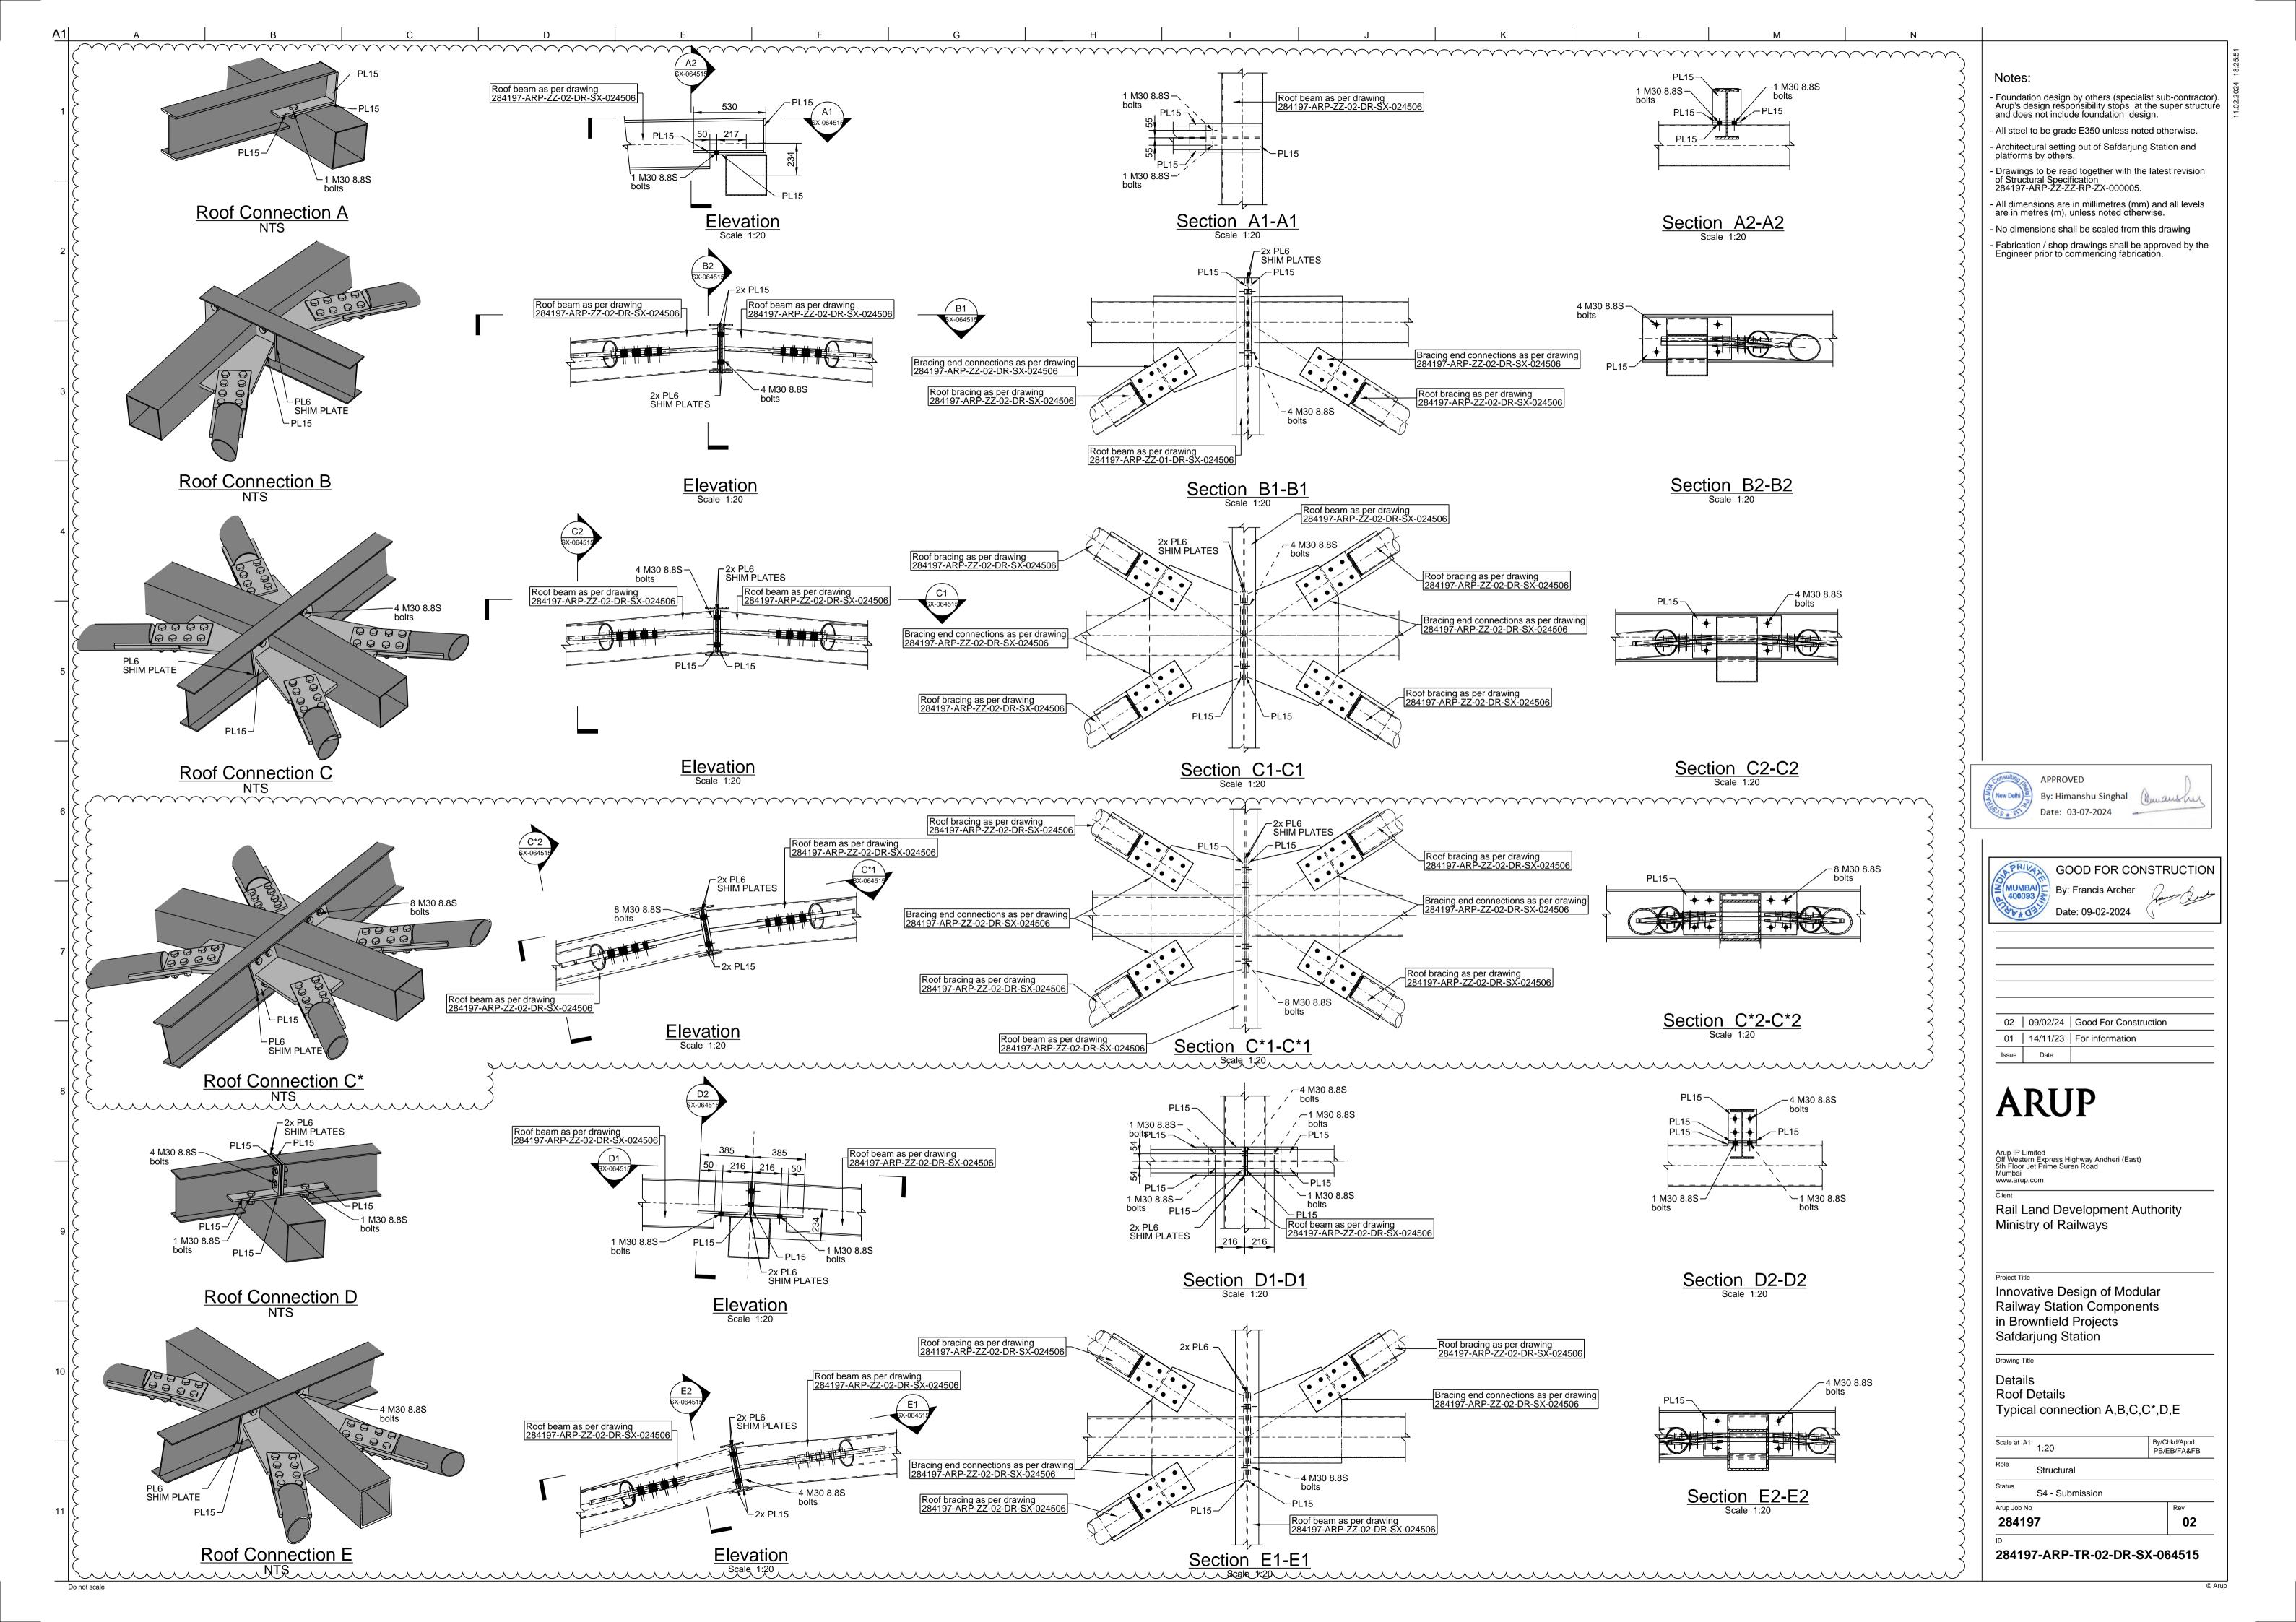

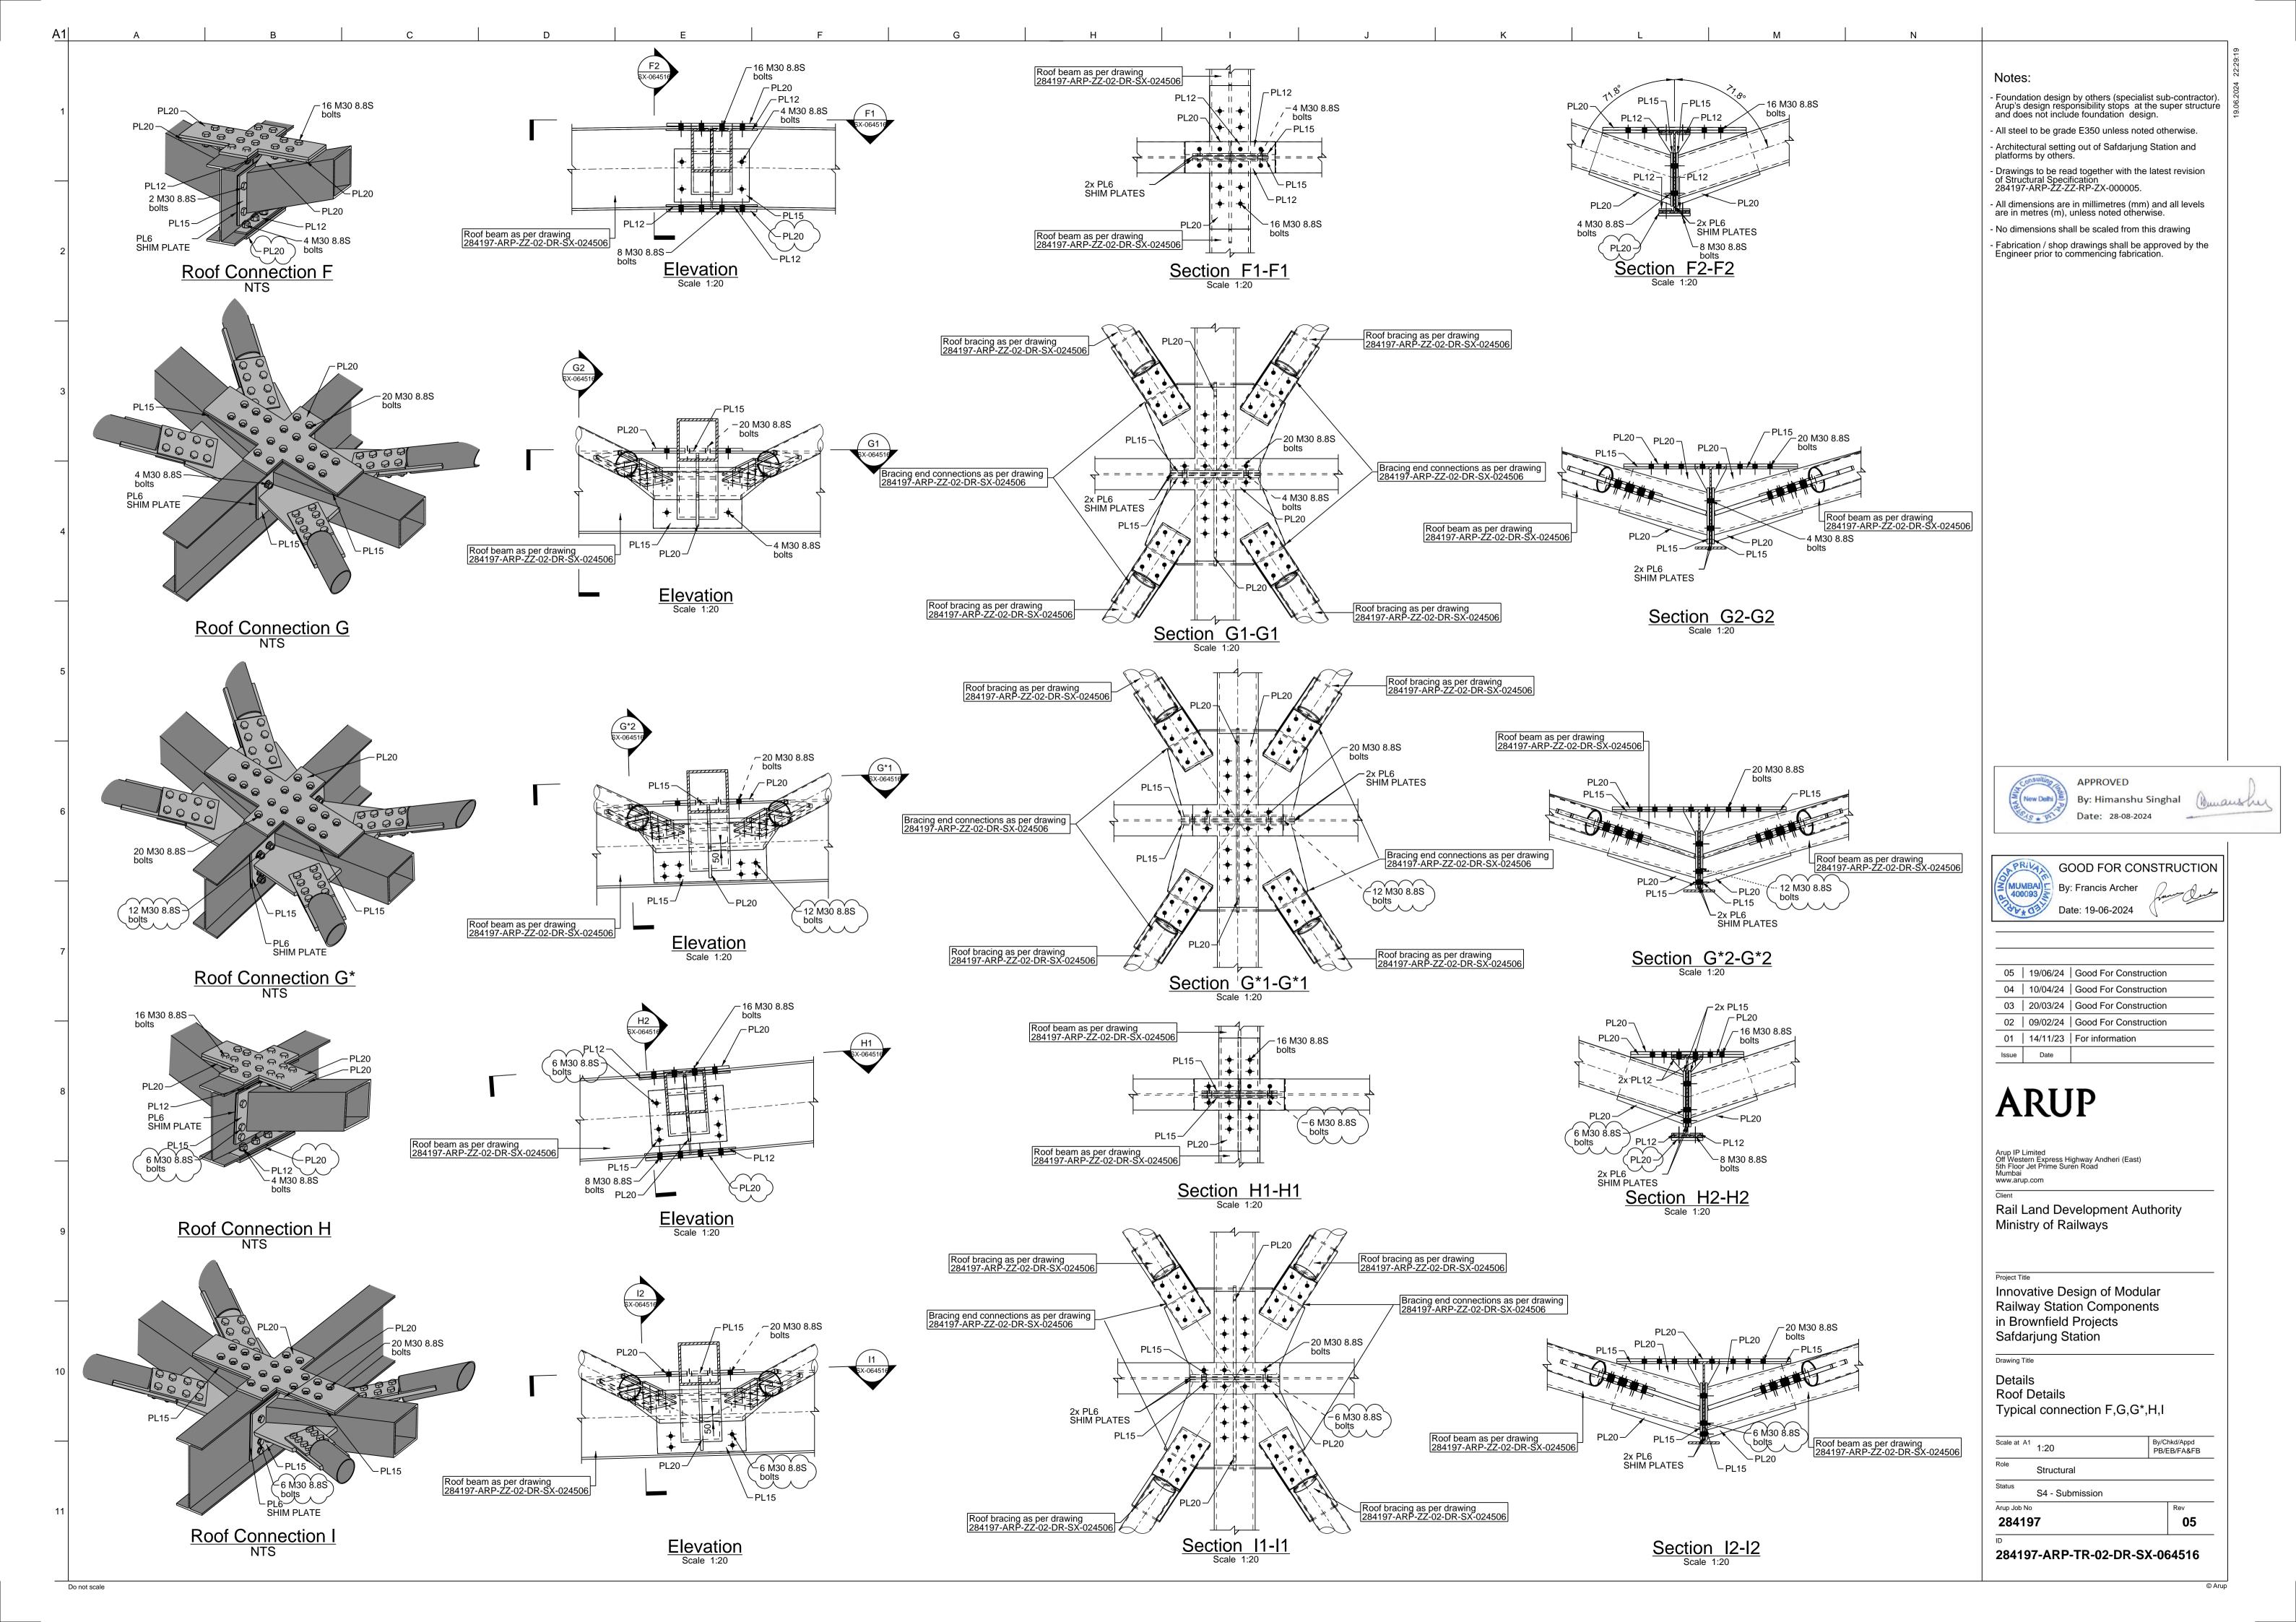

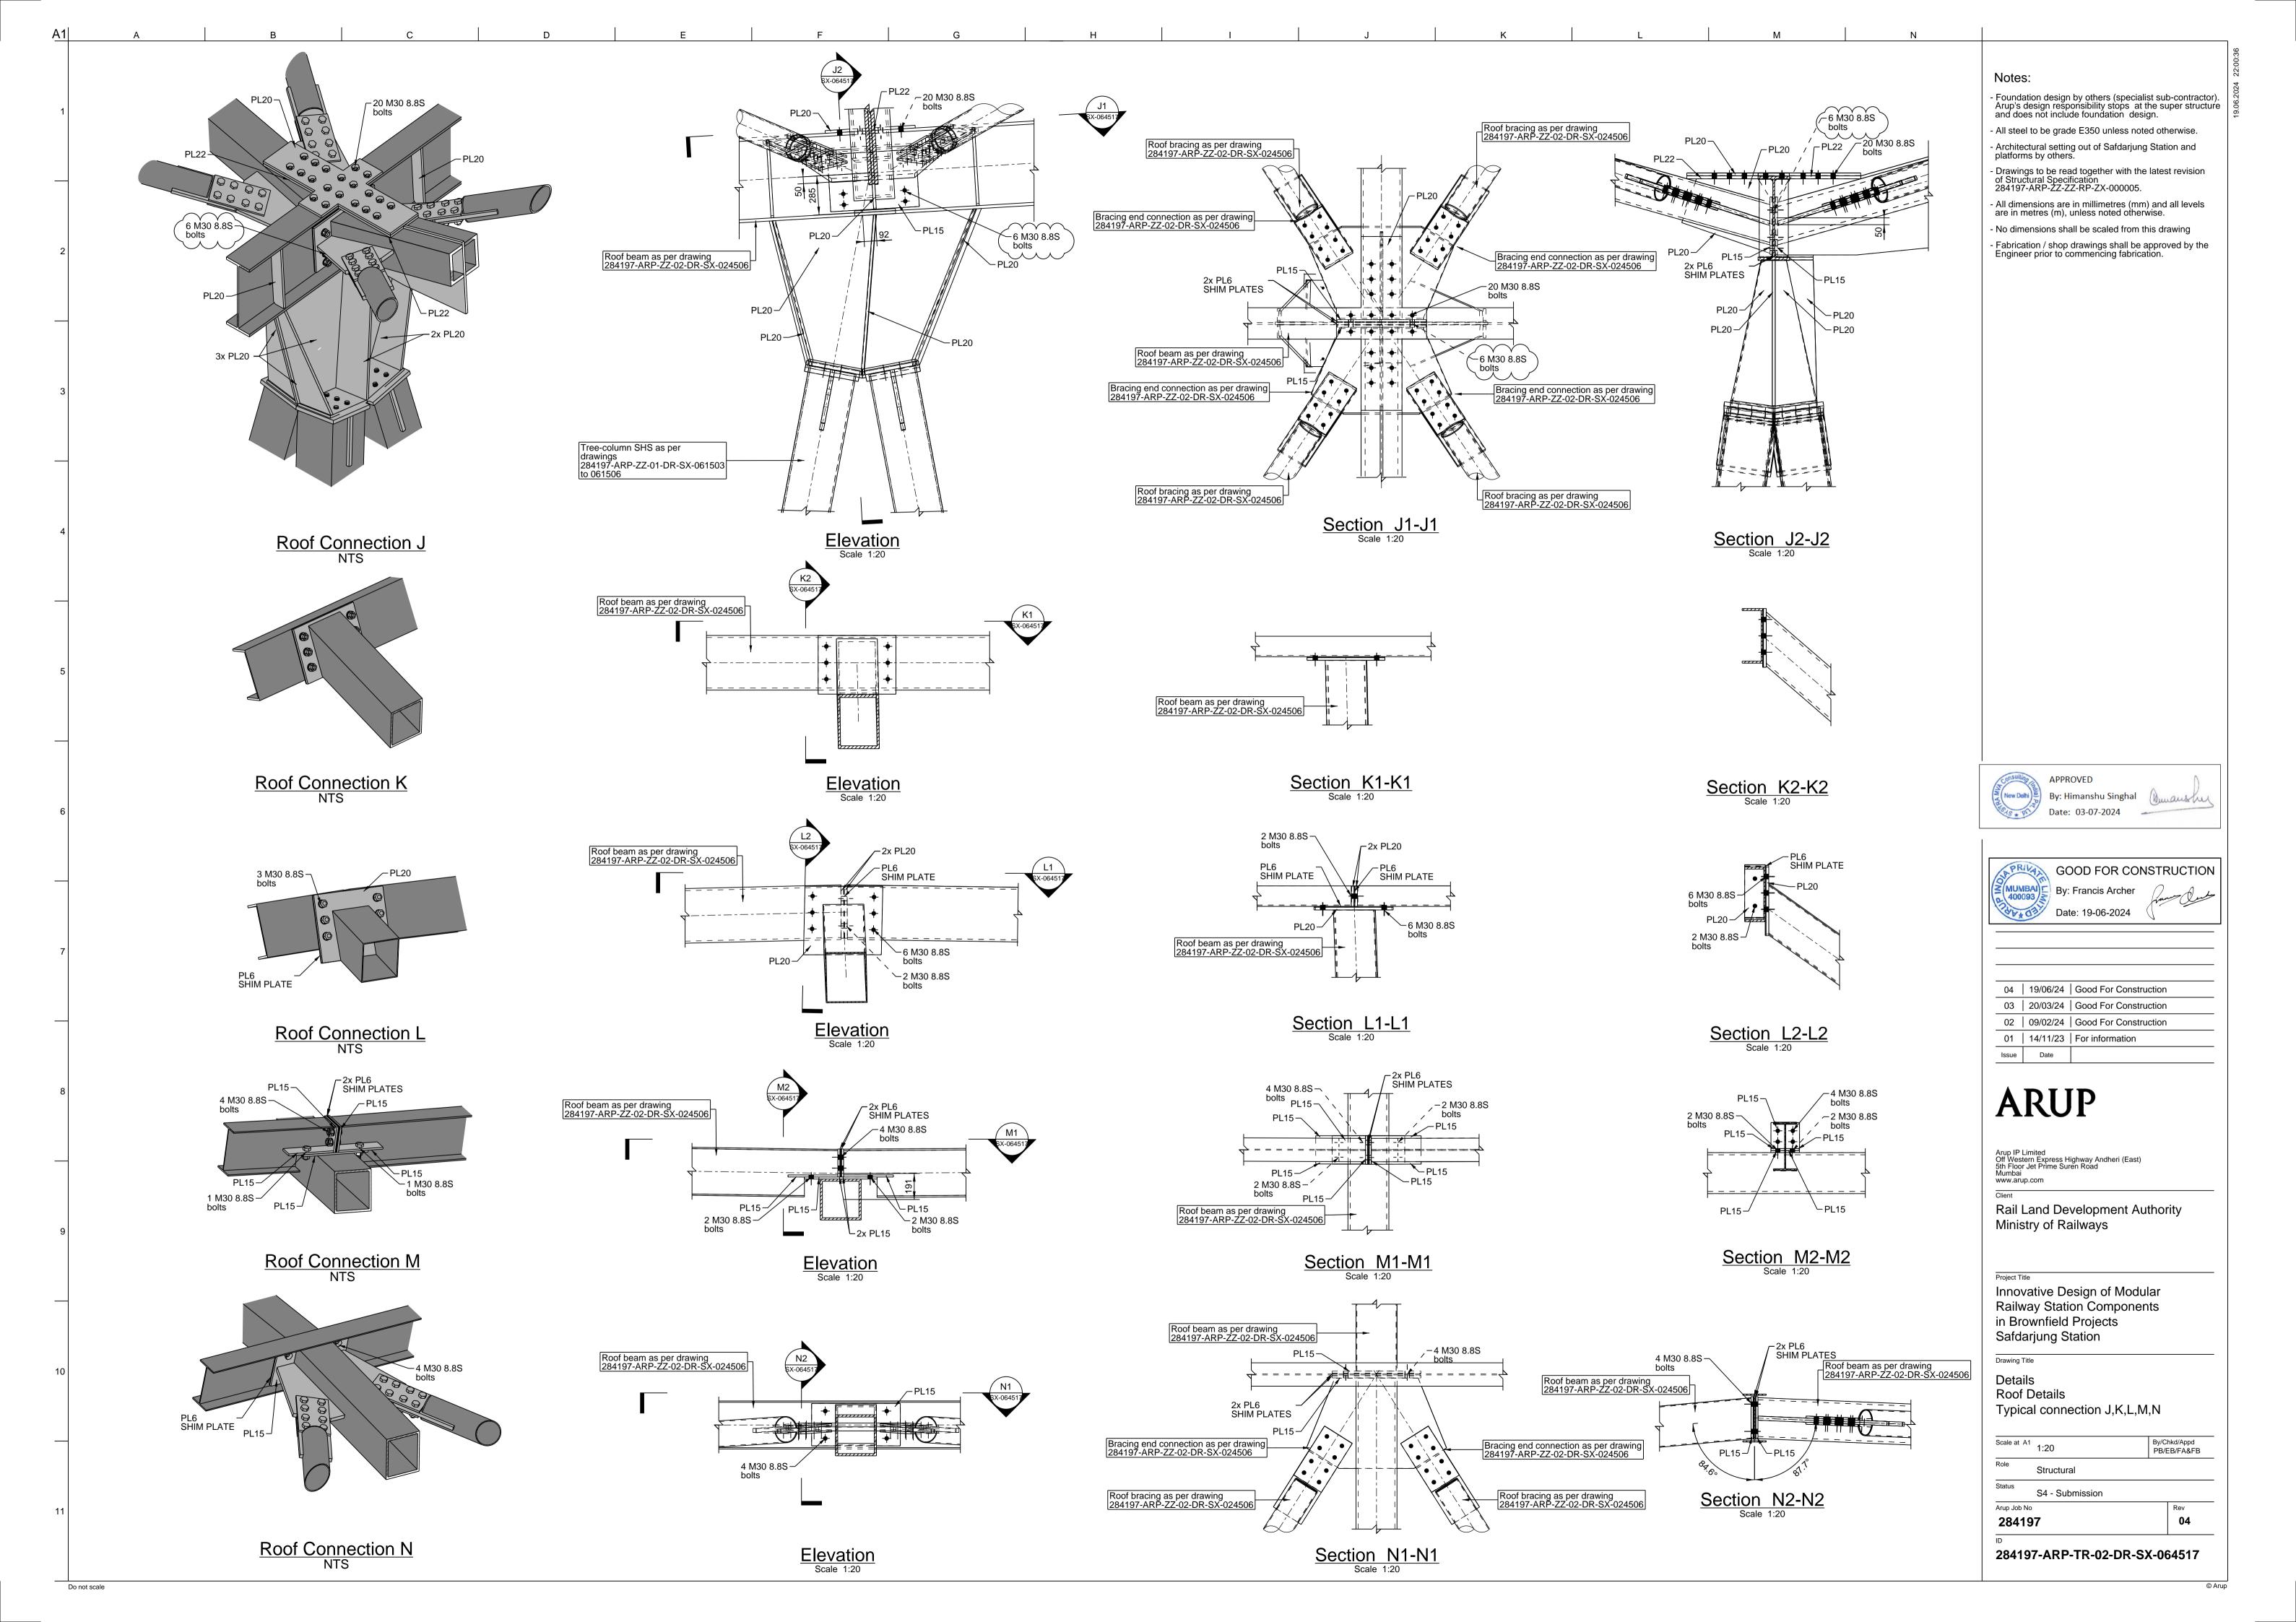

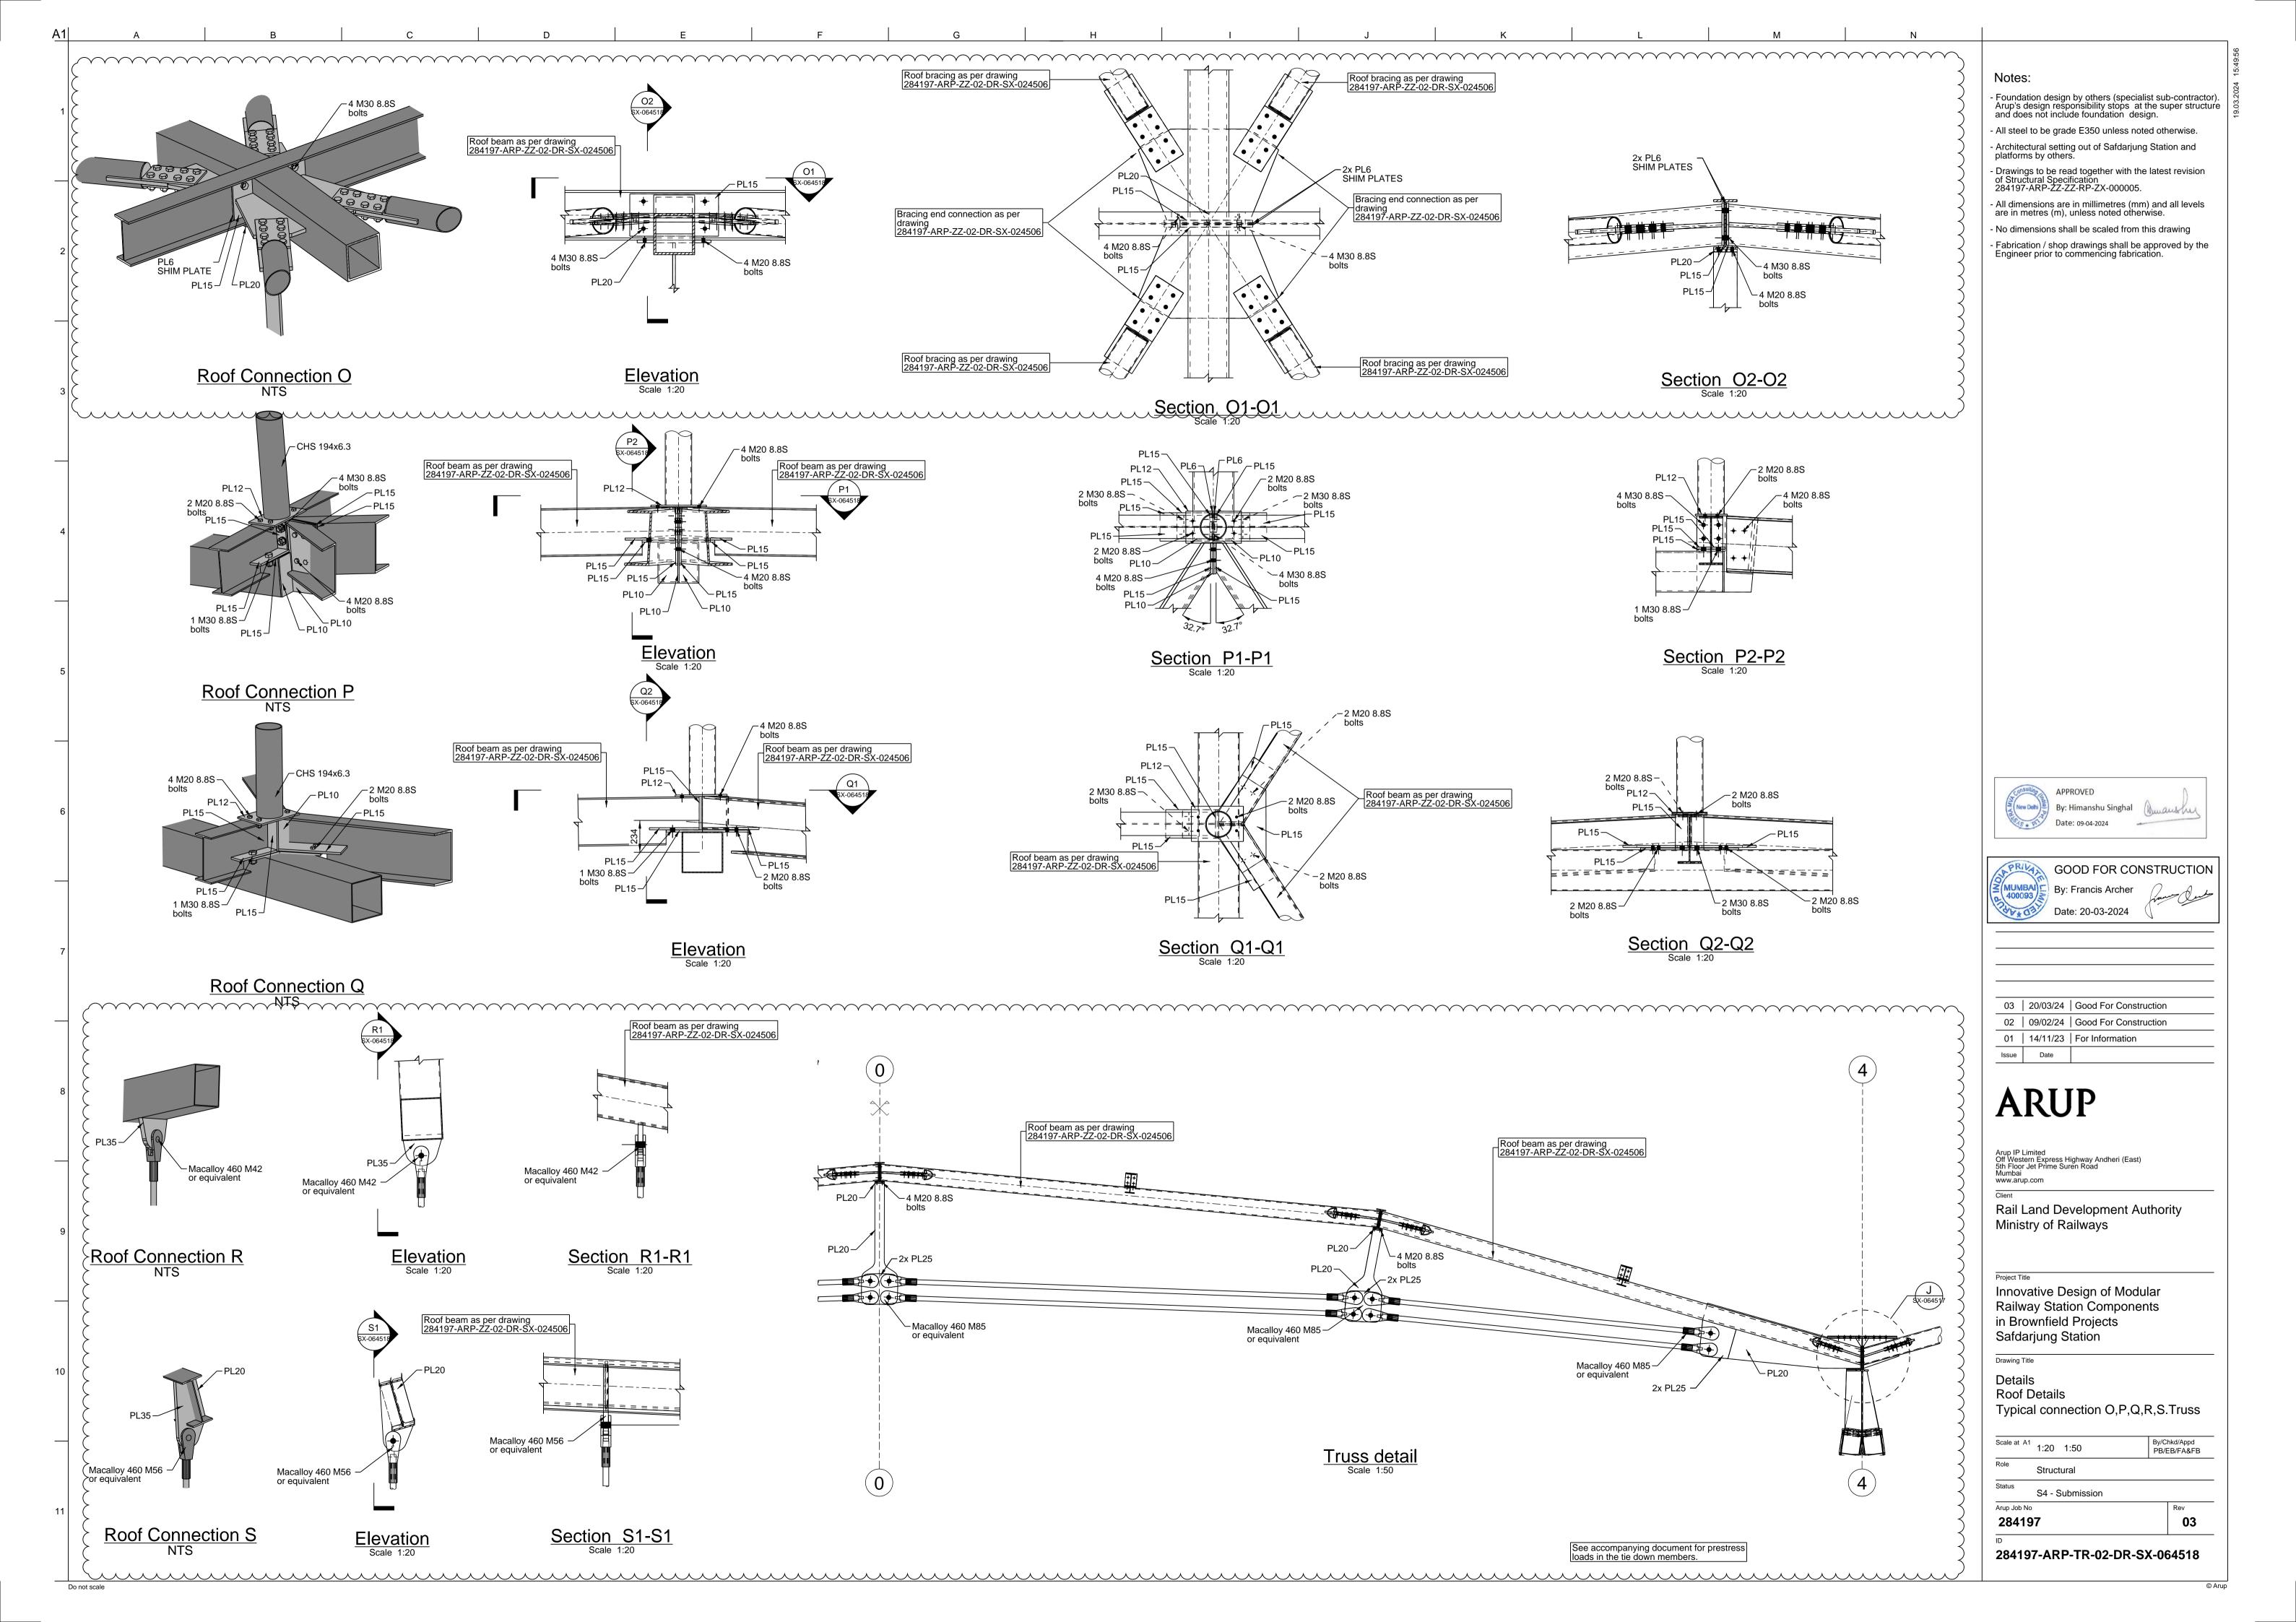

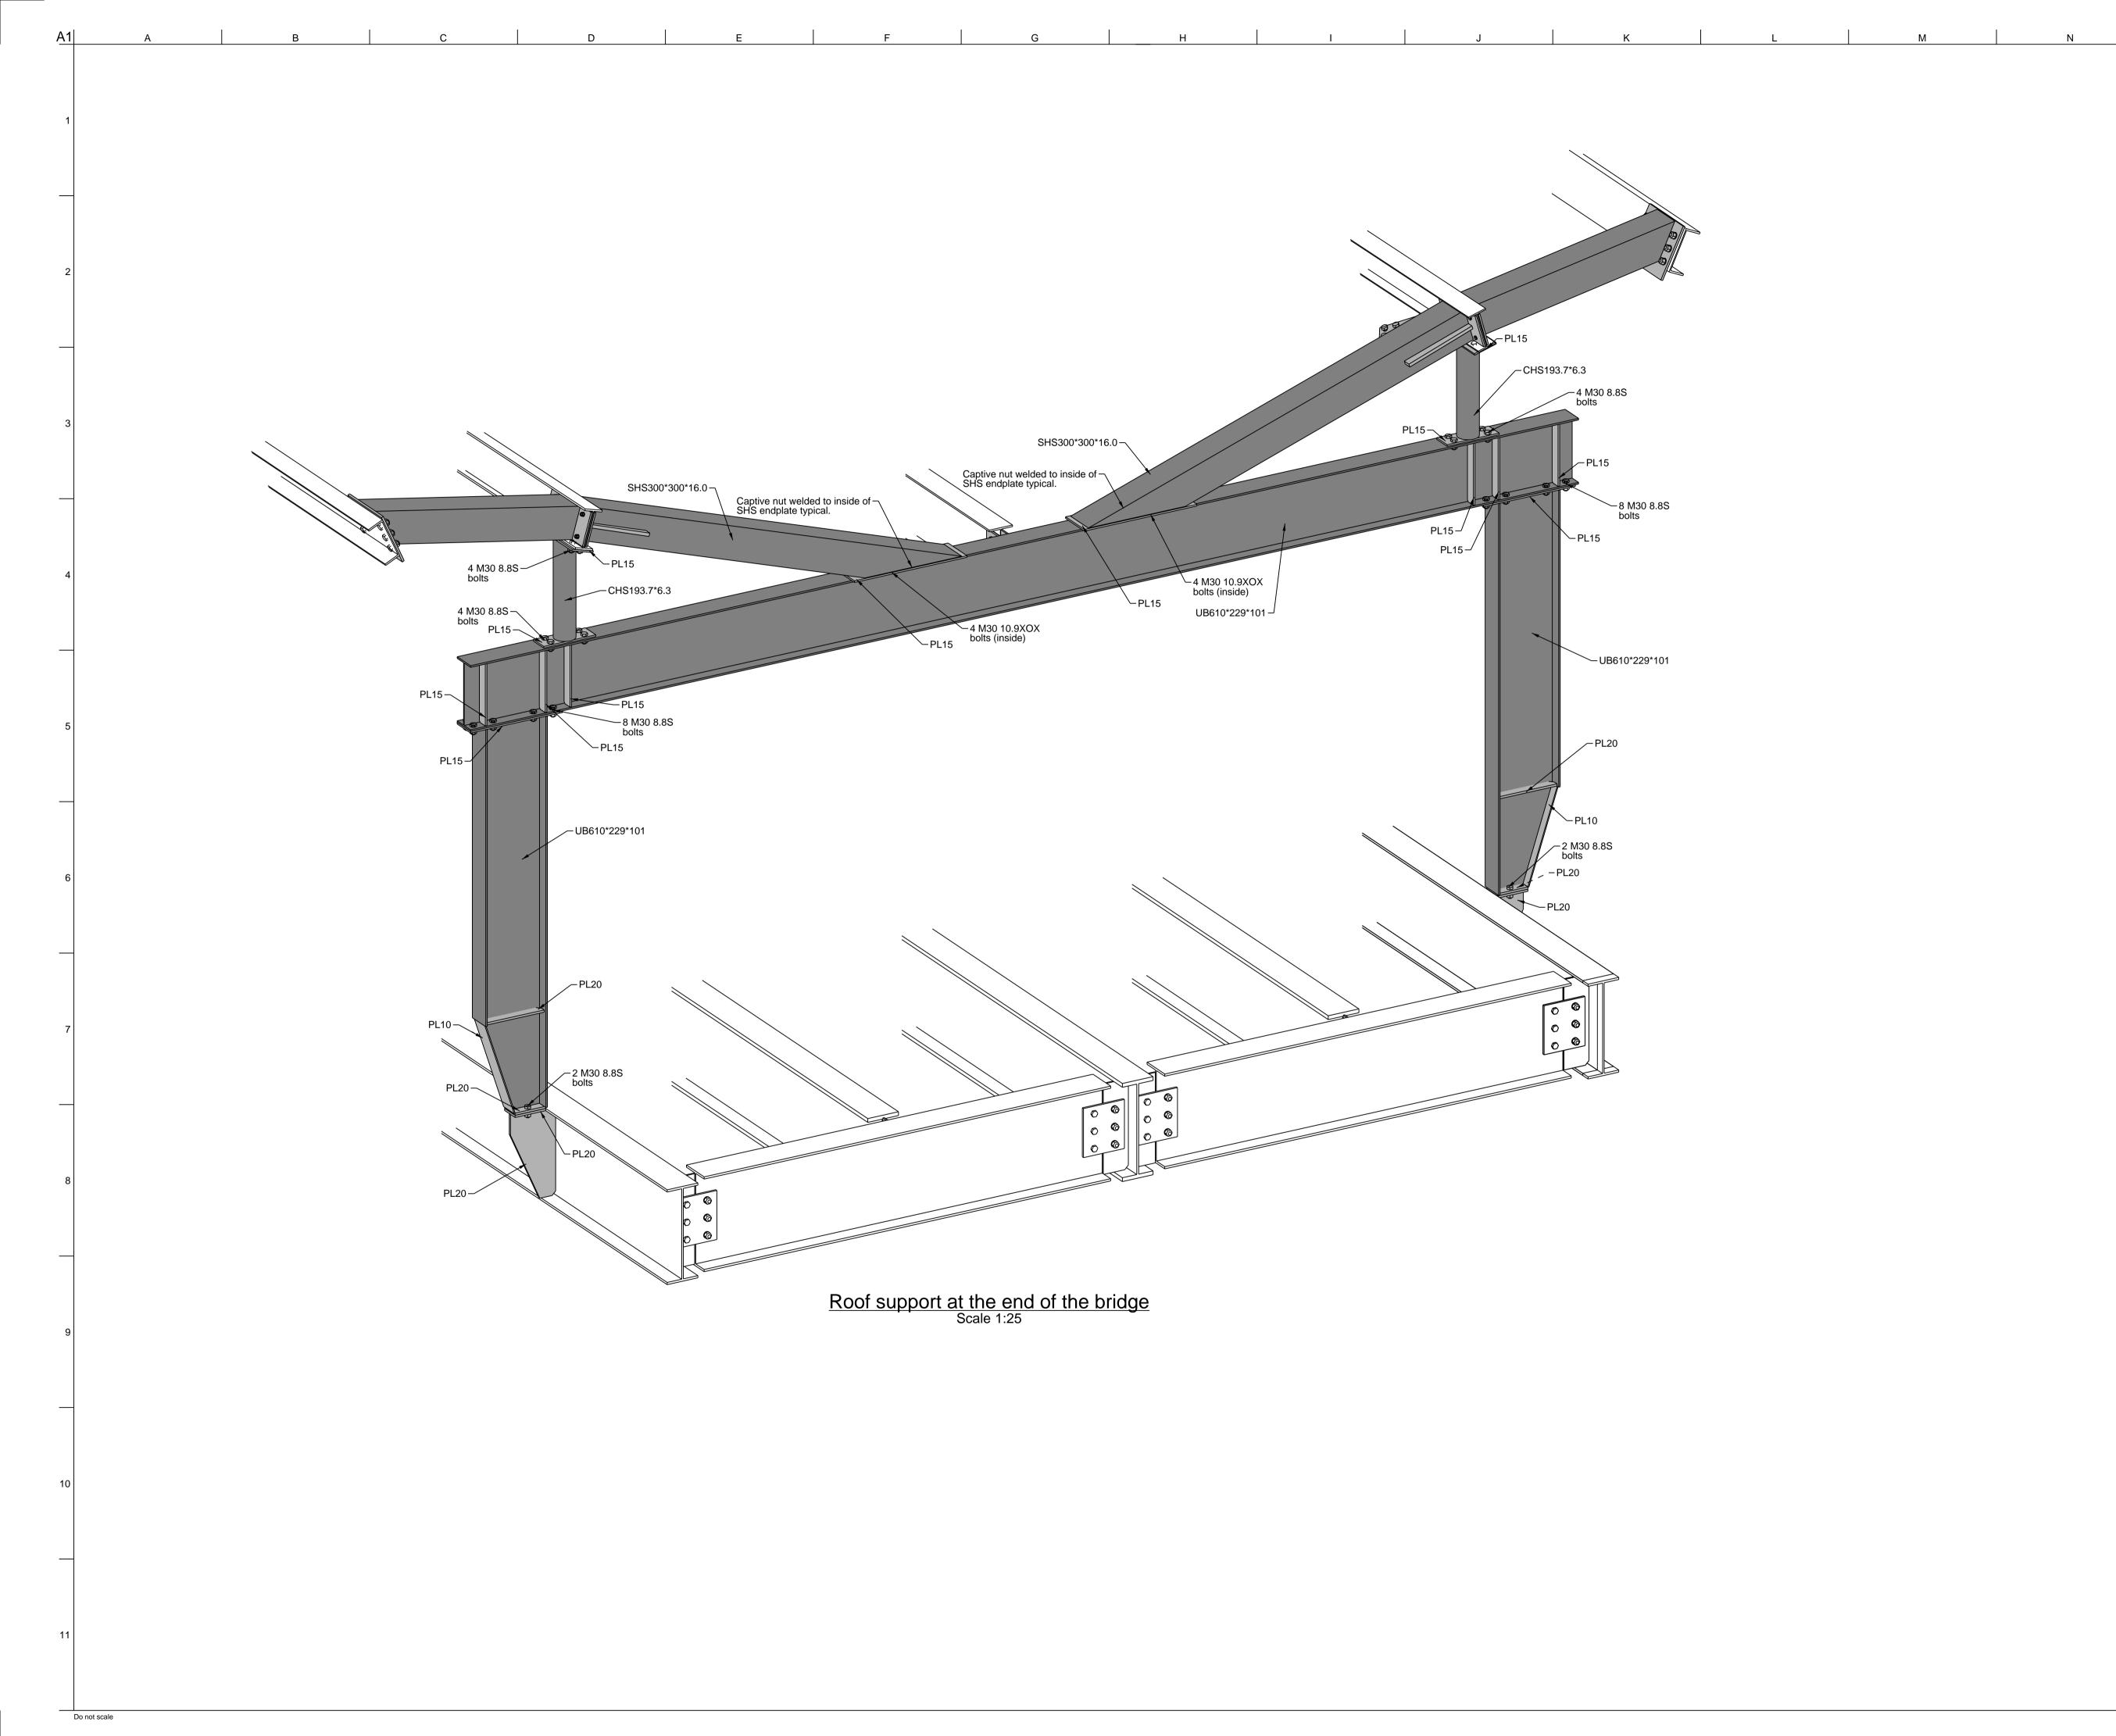

Notes:

- Foundation design by others (specialist sub-contractor).
Arup's design responsibility stops at the super structure and does not include foundation design.

- All steel to be grade E350 unless noted otherwise. Architectural setting out of Safdarjung Station and platforms by others.


Drawings to be read together with the latest revision of Structural Specification 284197-ARP-ZZ-ZZ-RP-ZX-000005.

- All dimensions are in millimetres (mm) and all levels are in metres (m), unless noted otherwise.

- No dimensions shall be scaled from this drawing

Fabrication / shop drawings shall be approved by the Engineer prior to commencing fabrication.



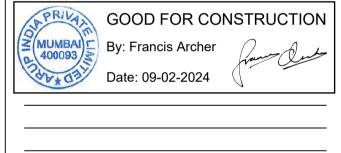

01 | 09/02/24 | Good For Construction Issue Date

## **ARUP**

Arup IP Limited Off Western Express Highway Andheri (East) 5th Floor Jet Prime Suren Road Mumbai www.arup.com

Rail Land Development Authority Ministry of Railways

Innovative Design of Modular Railway Station Components in Brownfield Projects Safdarjung Station

Drawing Title

Details Roof support at the end of the bridge

28419	97		01
Arup Job No			Rev
Status	S4 - Submission		
Role	Structural		
Scale at A1	1:25 1:50		Chkd/Appd EB/FA&FE

284197-ARP-FB-ZZ-DR-SX-064519